

PRODUCT NUMBER  
XXXXX-XXYHXLFXADDITIONAL CODE  
(SEE NOTE 1)LEAD FREE OPTION  
(SEE NOTE 1)PACKAGING OPTIONS  
(SEE NOTE 1)HIGH TEMPERATURE PLASTIC  
(SEE NOTE 1)NO OF  
POSITIONS  
(SEE NOTE 1)PIN PLATING  
(SEE SHEET 2)

BASE PART NO.

68000-X XX-XXX XXX LF

TAIL LENGTH (EXAMPLE BELOW)  
3.0mm=030 12.8mm=128 (SEE NOTE 15 & 16)MATING LENGTH (EXAMPLE BELOW)  
5.0mm=050 25.5mm=255 (SEE NOTE 15 & 16)TOTAL NUMBER OF POSITION  
FROM 1 THRU 36 POS. (SEE NOTE 1)PIN PLATING (SEE NOTE 13)  
1=0.76µm Au  
4= PURE TIN  
8=0.36µm Au

BASE PART NO.

 $\varnothing .020 / .51$  (M) U (M) V (S)


NOTE 4

 $.025 \pm .001$   
 $0.64 \pm .03$ 


TYP

 $.013$   
 $0.33$ 


MAX TYP

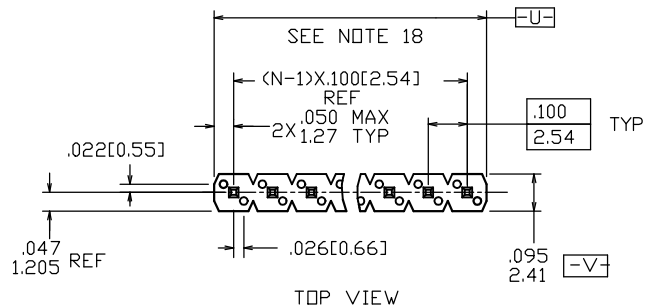 $25^\circ \pm 5^\circ$  TYP  
4 SIDESDETAIL P  
TYP BOTH ENDS

TOP VIEW

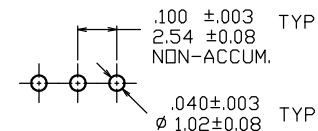


RECOMMENDED HOLE PATTERN

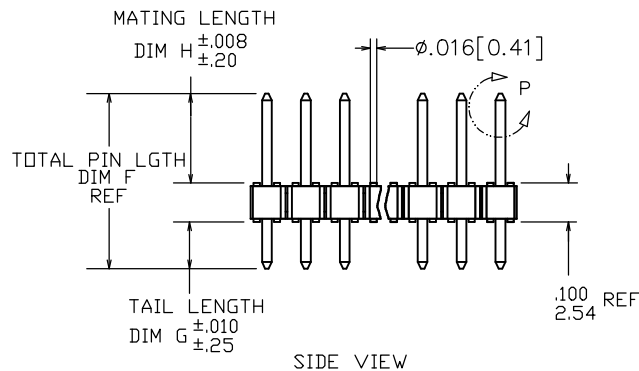


SIDE VIEW

NOTE 6

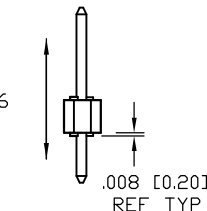

END VIEW



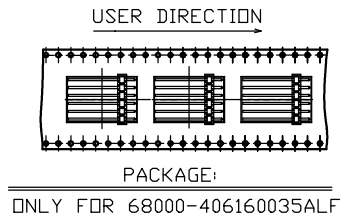


|                            |              |    |            |                                       |                                  |                |                                                         |    |    |    |
|----------------------------|--------------|----|------------|---------------------------------------|----------------------------------|----------------|---------------------------------------------------------|----|----|----|
| mat'l. code<br>NOTES 2 & 3 |              |    |            | surface<br>ISO 1302 ✓                 | tolerance<br>ISO 406<br>ISO 1101 | projection<br> | product family<br>BERGSTIK                              |    |    |    |
| ltr                        | ecn no       | dr | date       | tolerances unless otherwise specified |                                  | INCH/MM        | title<br>BERGSTIK® II HEADER<br>.100/2.54cc SR STRAIGHT |    |    |    |
| CY                         | ELX-N-011895 | JZ | 2012-06-12 | angles                                | .XX±01/.X±3                      |                |                                                         |    |    |    |
| DA                         | ELX-N-16105  | ZK | 2013-10-22 | linear                                | .XXX±0.006/.XX±.15               | scale 1:1      | dwg no<br>68000                                         |    |    |    |
| DB                         | ELX-N-17329  | ZK | 2014-03-27 | 0°±2'                                 | .XXX±0.0002/.XXX±.005            |                |                                                         |    |    |    |
| DC                         | ELX-N-28578  | MZ | 2017-11-23 | dr                                    | T.BREWBAKER                      | 01/05/95       | Amphenol<br>FCI                                         |    |    |    |
| DD                         | ELX-N-35840  | MZ | 2020-01-08 | engr                                  | T.HANNA                          | 01/05/95       |                                                         |    |    |    |
| DE                         | ELX-N-38872  | MX | 2020-11-04 | chr                                   | J.MURPHY                         | 01/05/95       | type Product Customer Drawing                           |    |    |    |
| DF                         | ELX-N-39694  | MX | 2020-12-17 | appd                                  | T.HANNA                          | 01/05/95       |                                                         |    |    |    |
| sheet                      | revision     | DF | DF         | DF                                    | DF                               | DF             | DF                                                      | DF | DF | DF |
| index                      | sheet        | 1  | 2          | 3                                     | 4                                | 5              | 6                                                       | 7  | 8  |    |


D

|              |                                                         |
|--------------|---------------------------------------------------------|
| XXXXX-1YY    | 30u"/0.76u MIN (SEE NOTE 13) OVER 50u"/1.27u MIN Ni     |
| XXXXX-2YY    | 15u"/0.38u MIN (SEE NOTE 13) OVER 50u"/1.27u MIN Ni     |
| XXXXX-3YY    | 50u"/1.27u MIN (SEE NOTE 13) OVER 50u"/1.27u MIN Ni     |
| XXXXX-4YY    | 100u"/2.54u MIN Sn OVER 50u"/1.27u MIN Ni (SEE NOTE 14) |
| XXXXX-4YYHLF |                                                         |
| XXXXX-5YY    | 15u"/0.38u MIN (SEE NOTE 13) OVER 50u"/1.27u MIN Ni     |
| XXXXX-6YY    | 30u"/0.76u MIN (SEE NOTE 13) OVER 50u"/1.27u MIN Ni     |
| XXXXX-7YY    | 30u"/0.76u MIN (SEE NOTE 13) OVER 50u"/1.27u MIN Ni     |
| XXXXX-8YY    | 15u"/0.38u MIN (SEE NOTE 13) OVER 50u"/1.27u MIN Ni     |
| XXXXX-9YY    | 15u"/0.38u MIN (SEE NOTE 13) OVER 50u"/1.27u MIN Ni     |
| XXXXX-0YY    | 30u"/0.76u MIN (SEE NOTE 13) OVER 50u"/1.27u MIN Ni     |

# BERGSTRIPTM HEADER

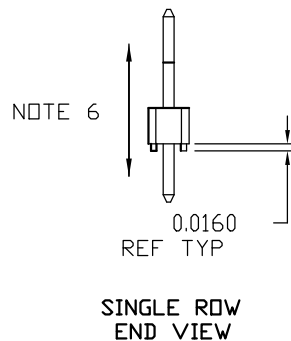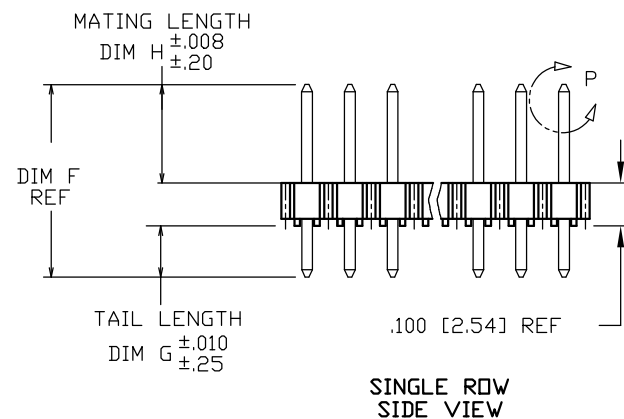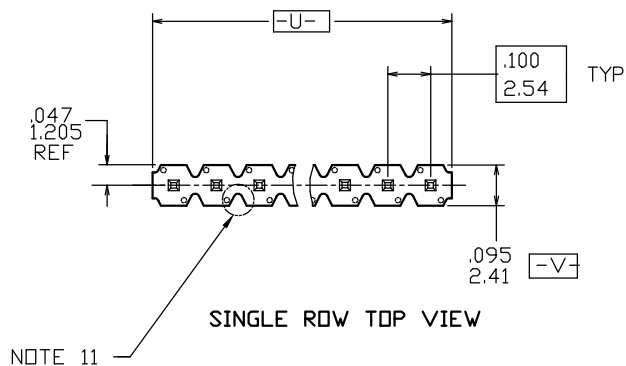

## REEL PACKING DIMENSIONS

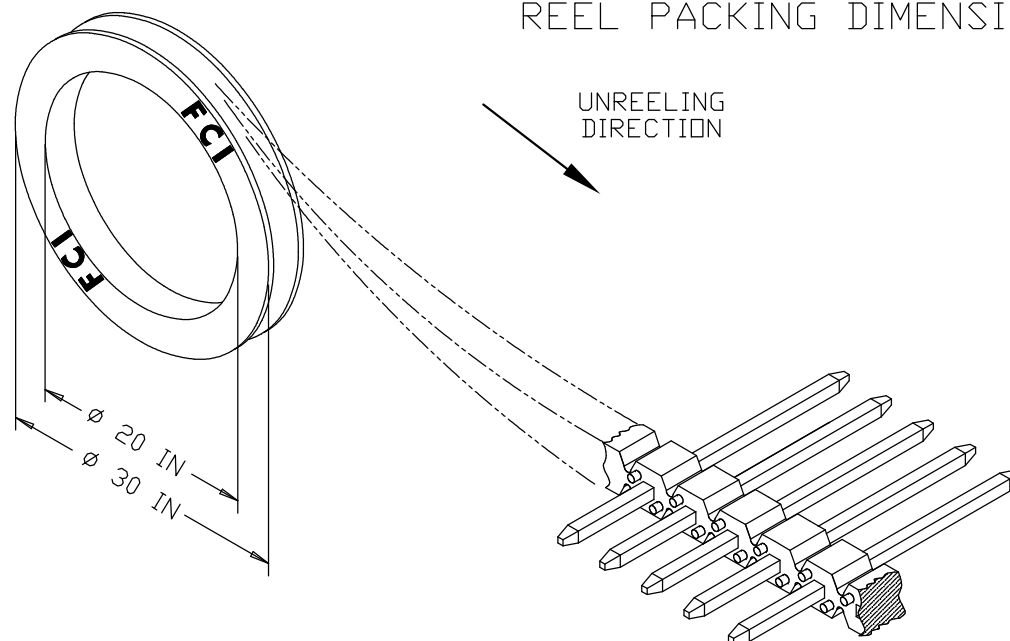

|                            |                |    |      |                                       |                                  |                                    |                                                         |  |              |      |
|----------------------------|----------------|----|------|---------------------------------------|----------------------------------|------------------------------------|---------------------------------------------------------|--|--------------|------|
| mat'l. code<br>NOTES 2 & 3 |                |    |      | surface<br>ISO 1302 ✓                 | tolerance<br>ISO 406<br>ISO 1101 | projection<br>INCH/MM<br>scale 1:1 | product family<br>BERGSTIK                              |  |              |      |
| ltr                        | ecn no         | dr | date | tolerances unless otherwise specified |                                  | Amphenol<br>FCI                    | title<br>BERGSTIK® II HEADER<br>.100/2.54cc SR STRAIGHT |  |              |      |
| DF                         |                |    |      | angles                                | .XX±01/.X±3                      |                                    |                                                         |  |              |      |
|                            |                |    |      | linear                                | .XXX±0.006/.XX±.15               |                                    |                                                         |  |              |      |
|                            |                |    |      | 0'±2'                                 | .XXXX±0.0002/.XXX±.005           |                                    |                                                         |  |              |      |
|                            |                |    |      | dr                                    | T.BREWBAKER 01/05/95             | Amphenol<br>FCI                    | dwg no                                                  |  | sheet 3 of 8 | size |
|                            |                |    |      | enr                                   | T.HANNA 01/05/95                 |                                    | 68000                                                   |  |              | A3   |
|                            |                |    |      | chr                                   | J.MURPHY 01/05/95                |                                    |                                                         |  |              |      |
|                            |                |    |      | appd                                  | T.HANNA 01/05/95                 |                                    | type Product Customer Drawing                           |  |              |      |
| sheet index                | revision sheet |    |      |                                       |                                  |                                    |                                                         |  |              |      |

| |
|---|
| |
|---|

**Amphenol**  
**FCi**

© 2016 AFCI

D

|                            |     |                |    |      |                                       |                         |                                  |          |                                                                                                     |                                                                                                    |                                                         |  |              |  |      |
|----------------------------|-----|----------------|----|------|---------------------------------------|-------------------------|----------------------------------|----------|-----------------------------------------------------------------------------------------------------|----------------------------------------------------------------------------------------------------|---------------------------------------------------------|--|--------------|--|------|
| mat'l. code<br>NOTES 2 & 3 |     |                |    |      | surface<br>ISO 1302 ✓                 |                         | tolerance<br>ISO 406<br>ISO 1101 |          | projection<br> |                                                                                                    | product family<br>BERGSTIK                              |  |              |  |      |
| ltr                        | ecn | no             | dr | date | tolerances unless otherwise specified |                         |                                  |          |                                                                                                     | <br>scale 1:1 | title<br>BERGSTIK® II HEADER<br>.100/2.54cc SR STRAIGHT |  |              |  |      |
| DF                         |     |                |    |      | angles                                |                         | .XX±01/.X±3                      |          |                                                                                                     |                                                                                                    |                                                         |  |              |  |      |
|                            |     |                |    |      | linear                                | .XXX±0.006/.XX±.15      |                                  |          |                                                                                                     |                                                                                                    |                                                         |  |              |  |      |
|                            |     |                |    |      | 0±2°                                  | .XXXX±0.0002/.XXXX±.005 |                                  |          |                                                                                                     |                                                                                                    |                                                         |  |              |  |      |
|                            |     |                |    |      | dr                                    | T.BREWBAKER             |                                  | 01/05/95 |                                                                                                     | <b>Amphenol</b><br><b>FCI</b>                                                                      | dwg no                                                  |  | sheet 5 of 8 |  | size |
|                            |     |                |    |      | enr                                   | T.HANNA                 |                                  | 01/05/95 |                                                                                                     |                                                                                                    | 68000                                                   |  |              |  | A3   |
|                            |     |                |    |      | chr                                   | J.MURPHY                |                                  | 01/05/95 |                                                                                                     |                                                                                                    |                                                         |  |              |  |      |
|                            |     |                |    |      | appd                                  | T.HANNA                 |                                  | 01/05/95 |                                                                                                     |                                                                                                    |                                                         |  |              |  |      |
| sheet index                |     | revision sheet |    |      |                                       |                         |                                  |          |                                                                                                     |                                                                                                    | type Product Customer Drawing                           |  |              |  |      |

**Amphenol**  
**FCi**

D

C

D

1



Amphenol  
FCI  
© 2016 APCI

| PRODUCT NUMBER           | TOTAL PIN LGTH   |                  | TAIL LENGTH      |                  | MATING LENGTH    |                  |                      |                    | BERGSTRI       | LF<br>OPTION |           |
|--------------------------|------------------|------------------|------------------|------------------|------------------|------------------|----------------------|--------------------|----------------|--------------|-----------|
|                          | DIM F            | DIM F            | DIM G            | DIM G            | DIM H            | DIM H            |                      |                    | AVAILABLE      |              |           |
|                          | ENGLISH          | METRIC           | ENGLISH          | METRIC           | ENGLISH          | METRIC           | PACKAGING            |                    | NOTES          |              |           |
| <del>90522-XXX</del>     | <del>0.668</del> | <del>16.97</del> | <del>0.135</del> | <del>3.43</del>  | <del>0.433</del> | <del>11.00</del> | <del>POLY BAGS</del> | <del>NOTE 10</del> | <del>NO</del>  | OB           | NOTE 1,12 |
| <del>90547-XXX</del>     | <del>0.508</del> | <del>12.90</del> | <del>0.095</del> | <del>2.41</del>  | <del>0.313</del> | <del>7.95</del>  | <del>POLY BAGS</del> | <del>NOTE 10</del> | <del>NO</del>  | OB           |           |
| 90719-XXX                | 0.384            | 9.75             | 0.106            | 2.69             | 0.178            | 4.52             | POLY BAGS            | —                  | NO             |              |           |
| <del>90726-XXX</del>     | <del>0.440</del> | <del>11.18</del> | <del>0.110</del> | <del>2.79</del>  | <del>0.230</del> | <del>5.84</del>  | <del>POLY BAGS</del> | <del>—</del>       | <del>YES</del> | OB           |           |
| 91276-XXX                | 1.225            | 31.12            | 0.225            | 5.72             | 0.900            | 22.86            | POLY BAGS            | —                  | NO             |              |           |
| <del>92020-XXX</del>     | <del>0.372</del> | <del>9.45</del>  | <del>0.094</del> | <del>2.39</del>  | <del>0.178</del> | <del>4.52</del>  | <del>POLY BAGS</del> | <del>—</del>       | <del>NO</del>  | OB           |           |
| <del>92418-XXX</del>     | <del>0.572</del> | <del>14.53</del> | <del>0.118</del> | <del>3.00</del>  | <del>0.354</del> | <del>8.99</del>  | <del>POLY BAGS</del> | <del>—</del>       | <del>NO</del>  | OB           |           |
| <del>93167-XXX</del>     | <del>0.394</del> | <del>10.01</del> | <del>0.059</del> | <del>1.50</del>  | <del>0.235</del> | <del>5.97</del>  | <del>POLY BAGS</del> | <del>—</del>       | <del>NO</del>  | OB           |           |
| 93287-XXYH               | 0.585            | 14.86            | 0.085            | 2.16             | 0.400            | 10.16            | POLY BAGS            | —                  | NO             |              |           |
| 93944-XXX                | 0.941            | 23.90            | 0.130            | 3.30             | 0.711            | 18.06            | POLY BAGS            | —                  | NO             |              |           |
| 93992-XXYH               | 0.415            | 10.54            | 0.085            | 2.16             | 0.230            | 5.84             | POLY BAGS            | —                  | NO             |              |           |
| 94063-XXX                | 0.376            | 9.55             | 0.138            | 3.51             | 0.138            | 3.51             | POLY BAGS            | NOTE 10            | NO             |              |           |
| <del>94094-XXX</del>     | <del>0.592</del> | <del>15.04</del> | <del>0.314</del> | <del>7.98</del>  | <del>0.178</del> | <del>4.52</del>  | <del>POLY BAGS</del> | <del>—</del>       | <del>NO</del>  | OB           |           |
| <del>94544-XXX</del>     | <del>0.550</del> | <del>13.97</del> | <del>0.130</del> | <del>3.30</del>  | <del>0.330</del> | <del>8.38</del>  | <del>POLY BAGS</del> | <del>NOTE 10</del> | <del>NO</del>  | OB           |           |
| 94611-XXYH               | 0.320            | 8.13             | 0.095            | 2.41             | 0.125            | 3.18             | POLY BAGS            | —                  | NO             |              |           |
| <del>95017-XXYH</del>    | <del>0.560</del> | <del>14.22</del> | <del>0.060</del> | <del>1.52</del>  | <del>0.400</del> | <del>10.16</del> | <del>POLY BAGS</del> | <del>—</del>       | <del>NO</del>  | OB           |           |
| <del>95103-XXX</del>     | <del>1.064</del> | <del>27.03</del> | <del>0.433</del> | <del>11.00</del> | <del>0.531</del> | <del>13.49</del> | <del>POLY BAGS</del> | <del>NOTE 10</del> | <del>NO</del>  | OB           |           |
| <del>95104-XXX</del>     | <del>0.370</del> | <del>9.40</del>  | <del>0.126</del> | <del>3.20</del>  | <del>0.144</del> | <del>3.66</del>  | <del>POLY BAGS</del> | <del>NOTE 10</del> | <del>NO</del>  | OB           |           |
| <del>95648-XXYH</del>    | <del>0.655</del> | <del>16.64</del> | <del>0.155</del> | <del>3.94</del>  | <del>0.400</del> | <del>10.16</del> | <del>POLY BAGS</del> | <del>—</del>       | <del>NO</del>  | OB           |           |
| <del>95655-XXX</del>     | <del>1.164</del> | <del>29.57</del> | <del>0.095</del> | <del>2.41</del>  | <del>0.969</del> | <del>24.61</del> | <del>POLY BAGS</del> | <del>NOTE 10</del> | <del>NO</del>  | OB           |           |
| <del>98001-XXYH</del>    | <del>0.610</del> | <del>15.49</del> | <del>0.420</del> | <del>10.67</del> | <del>0.090</del> | <del>2.29</del>  | <del>POLY BAGS</del> | <del>—</del>       | <del>NO</del>  | OB           |           |
| <del>98136-XXYH</del>    | <del>0.475</del> | <del>12.07</del> | <del>0.095</del> | <del>2.41</del>  | <del>0.280</del> | <del>7.11</del>  | <del>POLY BAGS</del> | <del>—</del>       | <del>NO</del>  | OB           |           |
| <del>10004394-XXYH</del> | <del>0.290</del> | <del>7.37</del>  | <del>0.095</del> | <del>2.41</del>  | <del>0.095</del> | <del>2.41</del>  | <del>POLY BAGS</del> | <del>—</del>       | <del>NO</del>  | OB           |           |
| <del>10076764-XXYH</del> | <del>0.479</del> | <del>12.19</del> | <del>0.114</del> | <del>2.9</del>   | <del>0.265</del> | <del>6.75</del>  | <del>POLY BAGS</del> | <del>—</del>       | <del>YES</del> | OB           |           |
| <del>10103017-XXX</del>  | <del>0.335</del> | <del>8.51</del>  | <del>0.130</del> | <del>3.30</del>  | <del>0.105</del> | <del>2.67</del>  | <del>POLY BAGS</del> | <del>—</del>       | <del>NO</del>  | OB           |           |
| 10121349-XXX             | 0.626            | 15.9             | 0.120            | 3.05             | 0.406            | 10.3             | POLY BAGS/TAPE REEL  | —                  | NO             | NOTE 1,12    |           |

|                            |  |                |  |                                       |  |                                  |  |                                                                                                     |  |                                                         |  |  |  |  |  |
|----------------------------|--|----------------|--|---------------------------------------|--|----------------------------------|--|-----------------------------------------------------------------------------------------------------|--|---------------------------------------------------------|--|--|--|--|--|
| mat'l. code<br>NOTES 2 & 3 |  |                |  | surface<br>ISO 1302 ✓                 |  | tolerance<br>ISO 406<br>ISO 1101 |  | projection<br> |  | product family<br>BERGSTIK                              |  |  |  |  |  |
| ltr ecn no dr date         |  |                |  | tolerances unless otherwise specified |  |                                  |  | <br>INCH/MM    |  | title<br>BERGSTIK® II HEADER<br>.100/2.54cc SR STRAIGHT |  |  |  |  |  |
| DF                         |  |                |  | linear<br>linear<br>0±2'              |  |                                  |  |                                                                                                     |  | scale 1:1                                               |  |  |  |  |  |
|                            |  |                |  | dr                                    |  | T.BREWBAKER                      |  | 01/05/95                                                                                            |  | dwg no sheet 8 of 8 size                                |  |  |  |  |  |
|                            |  |                |  | enr                                   |  | T.HANNA                          |  | 01/05/95                                                                                            |  | 68000 A3                                                |  |  |  |  |  |
|                            |  |                |  | chr                                   |  | J.MURPHY                         |  | 01/05/95                                                                                            |  | type Product Customer Drawing                           |  |  |  |  |  |
|                            |  |                |  | appd                                  |  | T.HANNA                          |  | 01/05/95                                                                                            |  |                                                         |  |  |  |  |  |
| sheet index                |  | revision sheet |  |                                       |  |                                  |  |                                                                                                     |  |                                                         |  |  |  |  |  |



# Mouser Electronics

Authorized Distributor

Click to View Pricing, Inventory, Delivery & Lifecycle Information:

## FCI / Amphenol:

[78511-200HLF](#) [68418-436](#) [68497-136H](#) [68603-536](#) [69188-236H](#) [78511-200H](#) [78511-400H](#) [68653-436HLF](#)  
[68705-236H](#) [68717-236H](#) [68771-236HLF](#) [69173-436HLF](#) [68466-236HLF](#) [68497-136HLF](#) [68603-136HLF](#) [90719-136HLF](#)  
[90719-436HLF](#) [68771-436](#) [68717-336](#) [68497-103HLF](#) [68497-604](#) [68603-401H](#) [78511-100H](#) [78511-10278998-102](#)  
[68004-400H](#) [78998-136](#) [68004-200H](#) [68497-436](#) [68655-220](#) [68797-436H](#) [68603-136](#) [68717-43668603-112HLF](#)  
[69173-413HLF](#) [68603-220HLF](#) [68603-109HLF](#) [68603-106HLF](#) [69173-421HLF](#) [68797-210HLF](#)  
[68418-200HLF](#) [68000-402-058025LF](#) [78511-214HTLF](#) [68000-406HALF](#) [68905-101](#) [68000-406HQLF](#) [68000-406HDLF](#)  
[68024-103HALF](#) [68653-216HLF](#)