

|                              |                          |                      |
|------------------------------|--------------------------|----------------------|
| THIS DRAWING IS UNPUBLISHED. | RELEASED FOR PUBLICATION | 20                   |
| © COPYRIGHT 20               | BY -                     | ALL RIGHTS RESERVED. |



| PART<br>NUMBER         | REV          | FIRST<br>USED                              | A            | B              | C            | DESC                             |
|------------------------|--------------|--------------------------------------------|--------------|----------------|--------------|----------------------------------|
| 2215032-1              | C            | 2143331-7(2297082-3), 2143331-8(2297082-4) | 118.6        | 116            | 33.5         | 1X6 ASSY SEATING TOOL            |
| 2215032-2              | C            | 1-2057042-0, 1-2057042-1                   | 61.6         | 59             | 33.5         | 1X3 ASSY SEATING TOOL            |
| 2215032-3              | B            | 2170567-6, 2170567-7                       | 80.6         | 78             | 33.5         | 1X4 ASSY SEATING TOOL            |
| 2215032-4              | A            | 2143331-2(2297082-1), 2170023-2(2297082-2) | 118.6        | 116            | 28.5         | 1X6 ASSY SEATING TOOL            |
| <del>2-2215032-1</del> | <del>A</del> | <del>2143331-7, 2143331-8</del>            | <del>-</del> | <del>116</del> | <del>-</del> | <del>1X6 ASSY WALL SUPPORT</del> |
| <del>2-2215032-2</del> | <del>A</del> | <del>1-2057042-0, 1-2057042-1</del>        | <del>-</del> | <del>59</del>  | <del>-</del> | <del>1X3 ASSY WALL SUPPORT</del> |
| <del>2-2215032-3</del> | <del>A</del> | <del>2170567-6, 2170567-7</del>            | <del>-</del> | <del>78</del>  | <del>-</del> | <del>1X4 ASSY WALL SUPPORT</del> |


| REVISIONS |     |                   |           |     |      |
|-----------|-----|-------------------|-----------|-----|------|
| P         | LTR | DESCRIPTION       | DATE      | DWN | APVD |
|           | A   | INITIAL RELEASE   | 04JUN2014 | CZ  | VL   |
|           | B   | SEE ECR-15-008900 | 11JUN2015 | CZ  | VL   |
|           | C   | SEE ECR-17-010244 | 11JUL2017 | CZ  | DP   |
|           |     |                   |           |     |      |

**SUPERSEDED BY:**  
2215093-6

**SUPERSEDED BY:**  
2215093-3

**SUPERSEDED BY:**  
2215093-4

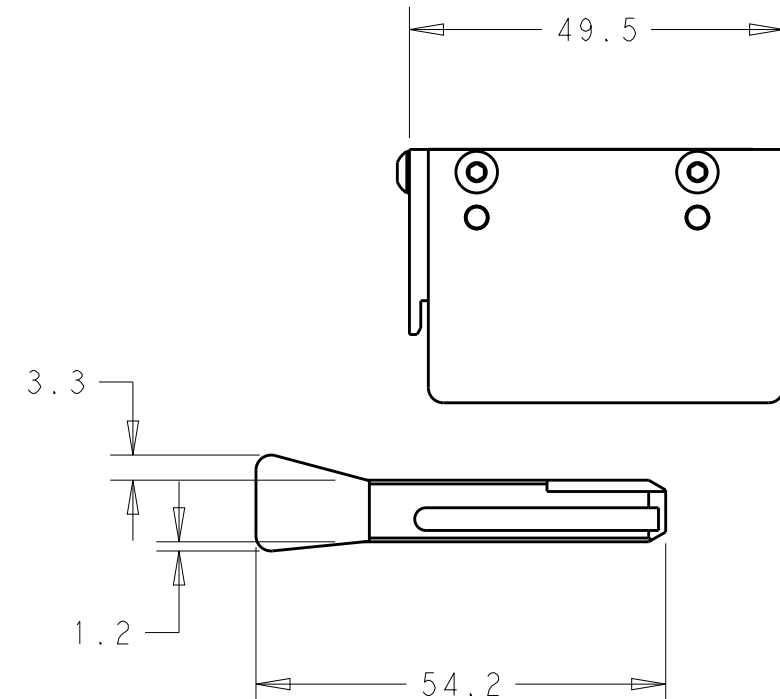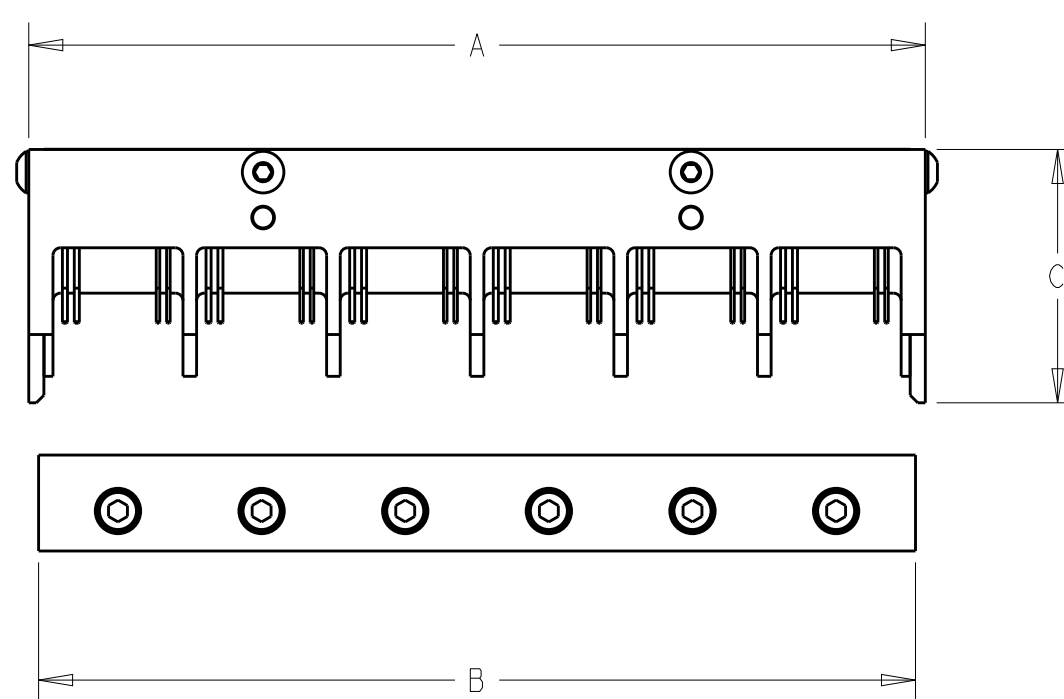
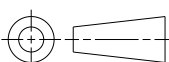
|                                                                                       |  |                                                                                                                 |  |                                                                                                                  |  |                         |  |                    |  |
|---------------------------------------------------------------------------------------|--|-----------------------------------------------------------------------------------------------------------------|--|------------------------------------------------------------------------------------------------------------------|--|-------------------------|--|--------------------|--|
| THIS DRAWING IS A CONTROLLED DOCUMENT.                                                |  | DWN<br>C. ZHU 29MAY2014                                                                                         |  | <div></div> TE Connectivity |  |                         |  |                    |  |
| DIMENSIONS:<br>mm                                                                     |  | CHK<br>E. PRICE 29MAY2014                                                                                       |  |                                                                                                                  |  |                         |  |                    |  |
|  |  | APVD<br>V. I. 29MAY2014                                                                                         |  | NAME<br>ASSY SEATING TOOL<br>QSFP, BEHIND BEZEL<br>-                                                             |  |                         |  |                    |  |
|                                                                                       |  | TOLERANCES UNLESS OTHERWISE SPECIFIED:<br>0 PLC ±-<br>1 PLC ±-<br>2 PLC ±-<br>3 PLC ±-<br>4 PLC ±-<br>ANGLES ±- |  |                                                                                                                  |  |                         |  |                    |  |
| MATERIAL<br>-                                                                         |  | PRODUCT SPEC<br>SEE NOTE                                                                                        |  | SIZE<br>A3                                                                                                       |  |                         |  |                    |  |
| FINISH<br>-                                                                           |  | APPLICATION SPEC<br>-                                                                                           |  |                                                                                                                  |  |                         |  |                    |  |
|                                                                                       |  | WEIGHT<br>-                                                                                                     |  | CAGE CODE<br>00779                                                                                               |  | DRAWING NO<br>C-2215032 |  | RESTRICTED TO<br>- |  |
| CUSTOMER DRAWING                                                                      |  |                                                                                                                 |  | SCALE<br>1:1                                                                                                     |  | SHEET<br>1 OF 1         |  | REV<br>C           |  |

# Mouser Electronics

Authorized Distributor

Click to View Pricing, Inventory, Delivery & Lifecycle Information:

[TE Connectivity:](#)

[2215032-1](#)