
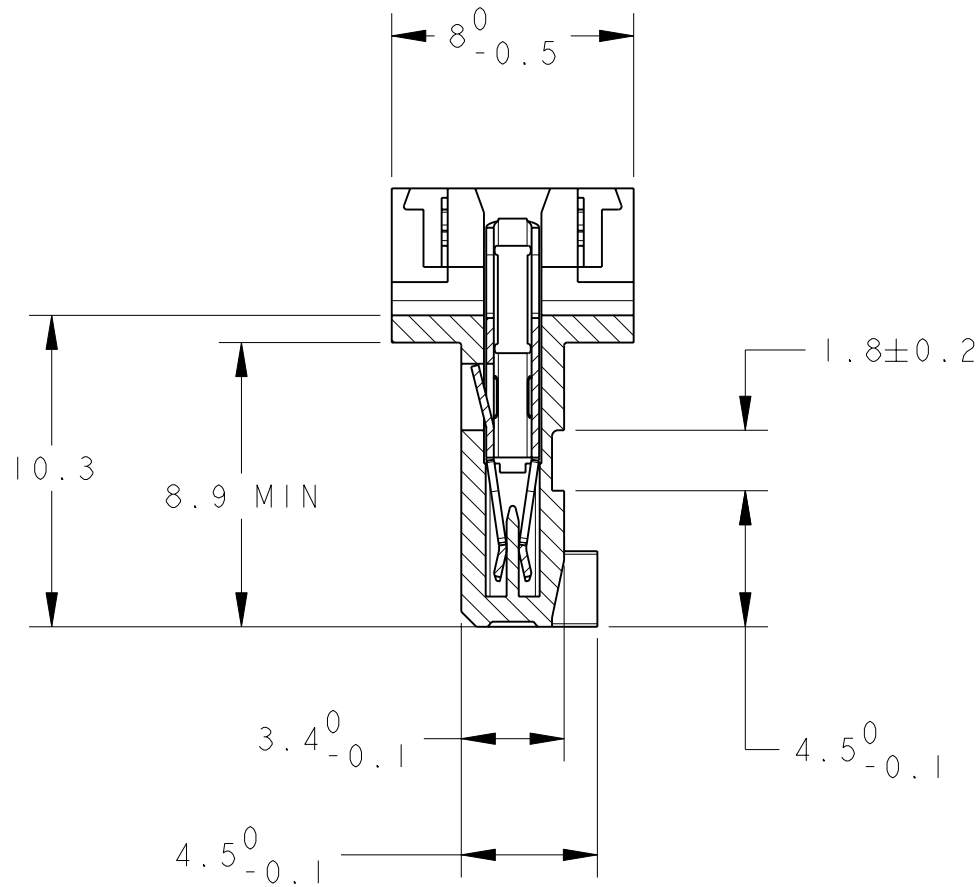
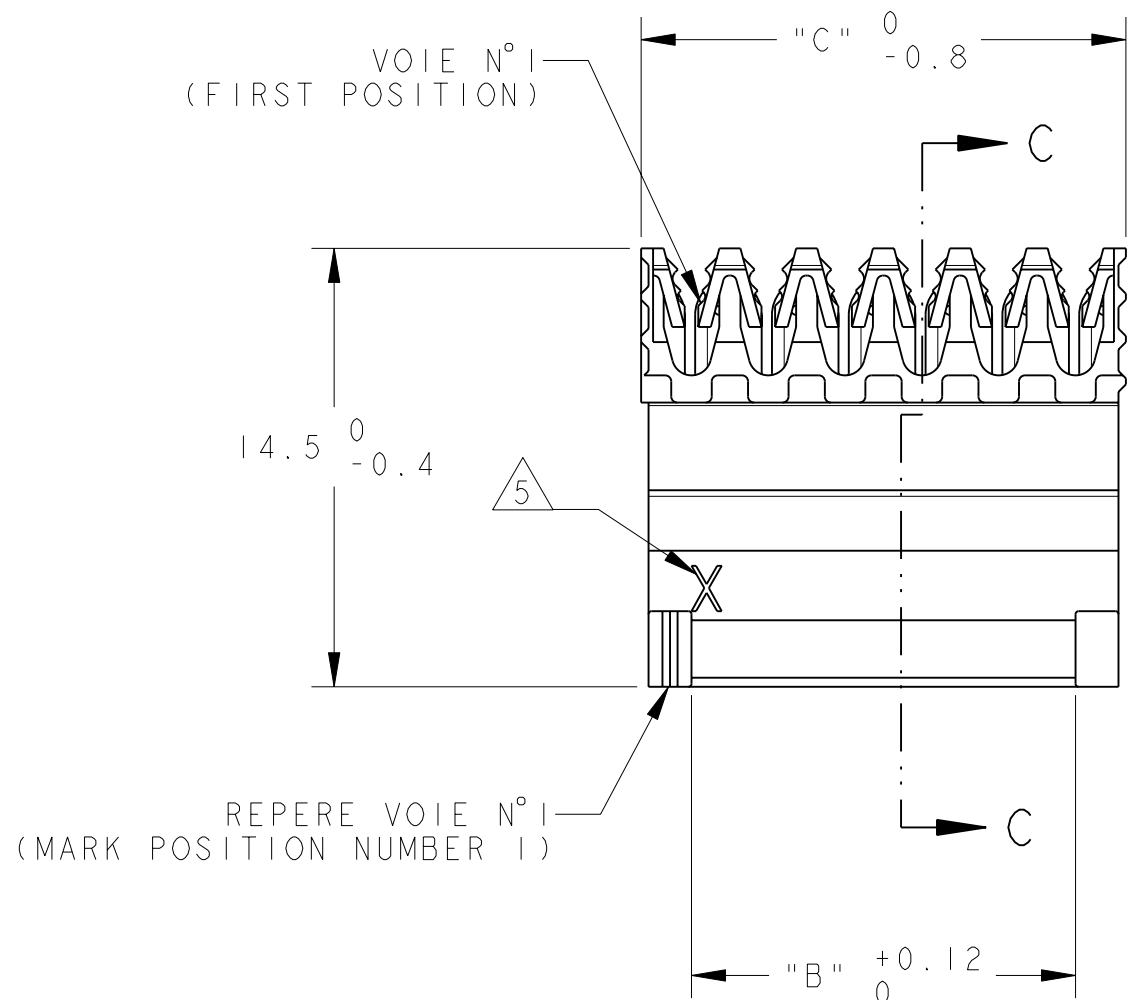
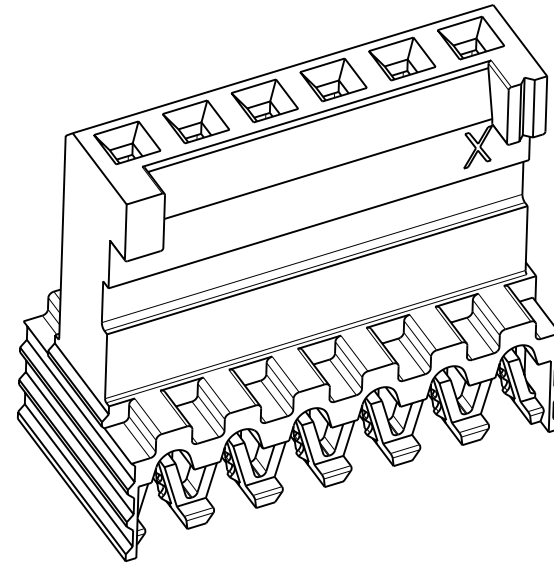
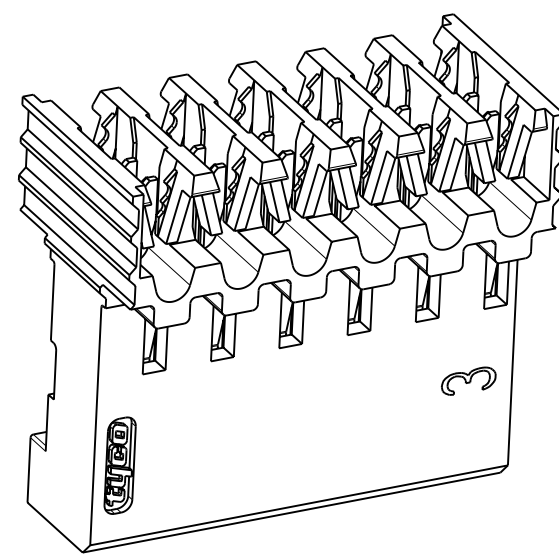



THIS DRAWING IS UNPUBLISHED. DIFFUSION RESTREINTE	RELEASED FOR PUBLICATION LIBRE A LA DIFFUSION	20
© COPYRIGHT 20	BY -	ALL RIGHTS RESERVED. TOUS DROITS RESERVES

FILS ADMISSIBLES (ACCEPTABLES WIRES)	
JAUGE (AWG) SECTION / 7 BRINS (7 STRANDS)	26 0.12mm <sup>2</sup>
ISOLANT: Ø MAX / MATIERE (INSUL.: Ø MAX / MAT'L)	Ø 1 / PVC


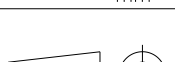


LOC F	DIST 7	REVISIONS					
		P	LTR	DESCRIPTION MODIFICATIONS	DATE	OWN DESS.	APVD APP.
			B2	REVISED PER ECO-11-005150	28MAR2011	RK	HMR

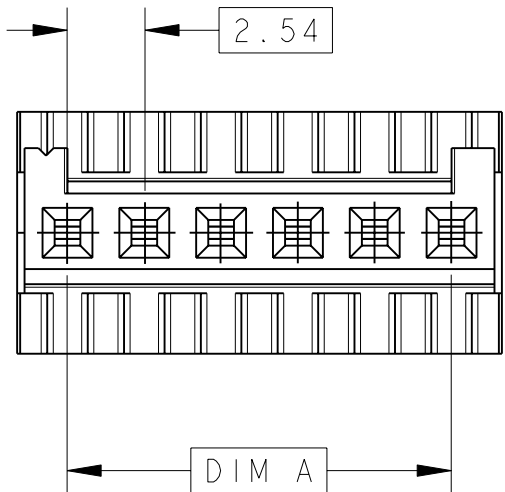

COUPE C - C

OBSOLETE	<del>9</del>	<del>64.30</del>	<del>60.96</del>	<del>25</del>	<del>2-281711-5</del>	<del>2-144271-5</del>
OBSOLETE	<del>9</del>	<del>61.76</del>	<del>58.42</del>	<del>24</del>	<del>2-281711-4</del>	<del>2-144271-4</del>
OBSOLETE	<del>10</del>	<del>59.22</del>	<del>55.88</del>	<del>23</del>	<del>2-281711-3</del>	<del>2-144271-3</del>
OBSOLETE	<del>10</del>	<del>56.68</del>	<del>53.34</del>	<del>22</del>	<del>2-281711-2</del>	<del>2-144271-2</del>
OBSOLETE	<del>10</del>	<del>54.14</del>	<del>50.80</del>	<del>21</del>	<del>2-281711-1</del>	<del>2-144271-1</del>
OBSOLETE	<del>11</del>	<del>51.60</del>	<del>48.26</del>	<del>20</del>	<del>2-281711-0</del>	<del>2-144271-0</del>
OBSOLETE	<del>12</del>	<del>49.06</del>	<del>45.72</del>	<del>19</del>	<del>1-281711-9</del>	<del>1-144271-9</del>
	12	46.52	43.18	18	1-281711-8 *	1-144271-8 *
OBSOLETE	<del>13</del>	<del>43.98</del>	<del>40.64</del>	<del>17</del>	<del>1-281711-7</del>	<del>1-144271-7</del>
OBSOLETE	<del>14</del>	<del>41.44</del>	<del>38.10</del>	<del>16</del>	<del>1-281711-6</del>	<del>1-144271-6</del>
	15	38.90	35.56	15	1-281711-5 *	1-144271-5 *
OBSOLETE	<del>16</del>	<del>36.36</del>	<del>33.02</del>	<del>14</del>	<del>1-281711-4</del>	<del>1-144271-4</del>
OBSOLETE	<del>17</del>	<del>33.82</del>	<del>30.48</del>	<del>13</del>	<del>1-281711-3</del>	<del>1-144271-3</del>
	18	31.28	27.94	12	1-281711-2 *	1-144271-2 *
OBSOLETE	<del>20</del>	<del>28.74</del>	<del>25.40</del>	<del>11</del>	<del>1-281711-1</del>	<del>1-144271-1</del>
	20	26.20	22.86	10	1-281711-0 *	1-144271-0 *
OBSOLETE	<del>25</del>	<del>23.66</del>	<del>20.32</del>	<del>9</del>	<del>0-281711-9</del>	<del>0-144271-9</del>
	25	21.12	17.78	8	0-281711-8 *	0-144271-8 *
OBSOLETE	<del>30</del>	<del>18.58</del>	<del>15.24</del>	<del>7</del>	<del>0-281711-7</del>	<del>0-144271-7</del>
	35	16.04	12.70	6	0-281711-6 *	0-144271-6 *
	40	13.50	10.16	5	0-281711-5 *	0-144271-5 *
	50	10.96	7.62	4	0-281711-4 *	0-144271-4 *
	70	8.42	5.08	3	0-281711-3 *	0-144271-3 *
	100	5.88	2.54	2	0-281711-2	0-144271-2
QUANT / TUBE	C		A, B	Nb DE POS		VRAC (L.P.)
	DIMENSIONS				REFERENCES (PART No)	

1	CES CONNECTEURS SONT PREVUS POUR ETRE ACCOUPLES AVEC LES EMBASES 'HEI402' SIMPLE RANGEE	(THESE CONNECTORS ARE DESIGNED TO BE MATED WITH 'HEI402' HEADERS SINGLE ROW)
2	LES REFERENCES SUIVIES D'UN ' * ' SONT LES VERSIONS NORMALISEES SELON LA 'CEI 603-8'	(THE PART-No FOLLOWED BY ' * ' ARE COVERED BY THE INTERNATIONAL STANDARD 'IEC 603-8')
3	REVETEMENT DES CONTACTS: ETAIN SANS PLOMB	(THE CONTACTS ARE TIN PLATED LEAD FREE)
4	CONNECTEURS CONDITIONNES SOUS TUBE PVC	(THESE CONNECTORS ARE PACKAGED IN TUBE)
5	' X ' EST REMPLACE PAR LE DEUXIEME CHIFFRE DES JAUGES AWG	(' X ' REPLACED BY THE SECOND DIGIT OF AWG AS DEFINED IN TABLE)
6	MATIERES - BOITIER: PBT UL94V0 - CONTACTS: BRONZE PHOSPHOREUX	(MATERIALS - CASE: PBT UL94V0 - CONTACTS: PHOSPHOR BRONZE)
7	OBSELETE PARTS: OBSELETE CIS STREAMLINING PER D.RENAUD/D.SINISI	

THIS DRAWING IS A CONTROLLED DOCUMENT.		DWN/DESSINE C 17NOV2000 C COMBEDOUZON CHK/VERIFIE I 17NOV2000 I CORRIOL APVD/APROUVE Y 17NOV2000 Y PETRONIN		 TE Connectivity	
DIMENSIONS: mm 		TOLERANCES UNLESS OTHERWISE SPECIFIED: TOLERANCES NON SPECIFIEES (SUIV NB DE DECIMALES) 0 PLC/DEC: ± 1 PLC/DEC: ±0.3 2 PLC/DEC: ± 3 PLC/DEC: ± 4 PLC/DEC: ± ANGLES ±°		NAME TITRE HE 1402 PLUG 90deg IDC SINGLE ROW -	
MATERIAL/MATIERE		FINISH/FINITION		WEIGHT MASSE APPROX. -	
				SIZE FORMAT CAGE CODE DRAWING NO No PLAN A200779 C=281711	
CUSTOMER DRAWING /PLAN CLIENT				UNIFORME POUR REFERENCE SCALE ECHELLE 4:1	
				SHEET FEUILLE 1 OF 1 REV B2	

# Mouser Electronics

Authorized Distributor

Click to View Pricing, Inventory, Delivery & Lifecycle Information:

[TE Connectivity:](#)

[144271-3](#)