


DRAWING MADE IN AMERICAN PROJECTION

LOC  
GSHEET  
14

© 1970 BY AMP INCORPORATED. ALL RIGHTS RESERVED. AMP PRODUCTS COVERED BY PATENTS AND/OR PATENTS PENDING.

## REVISIONS

LTR	DESCRIPTION	DATE	APPROVED
D	<del>REV PER G-5711</del>	2/1/88	2/C
E	REV PER G-5711	2/24/90	OKS/18-C
C	331366 OBSOLETE G-2340	DAP 4/10/87	qcm

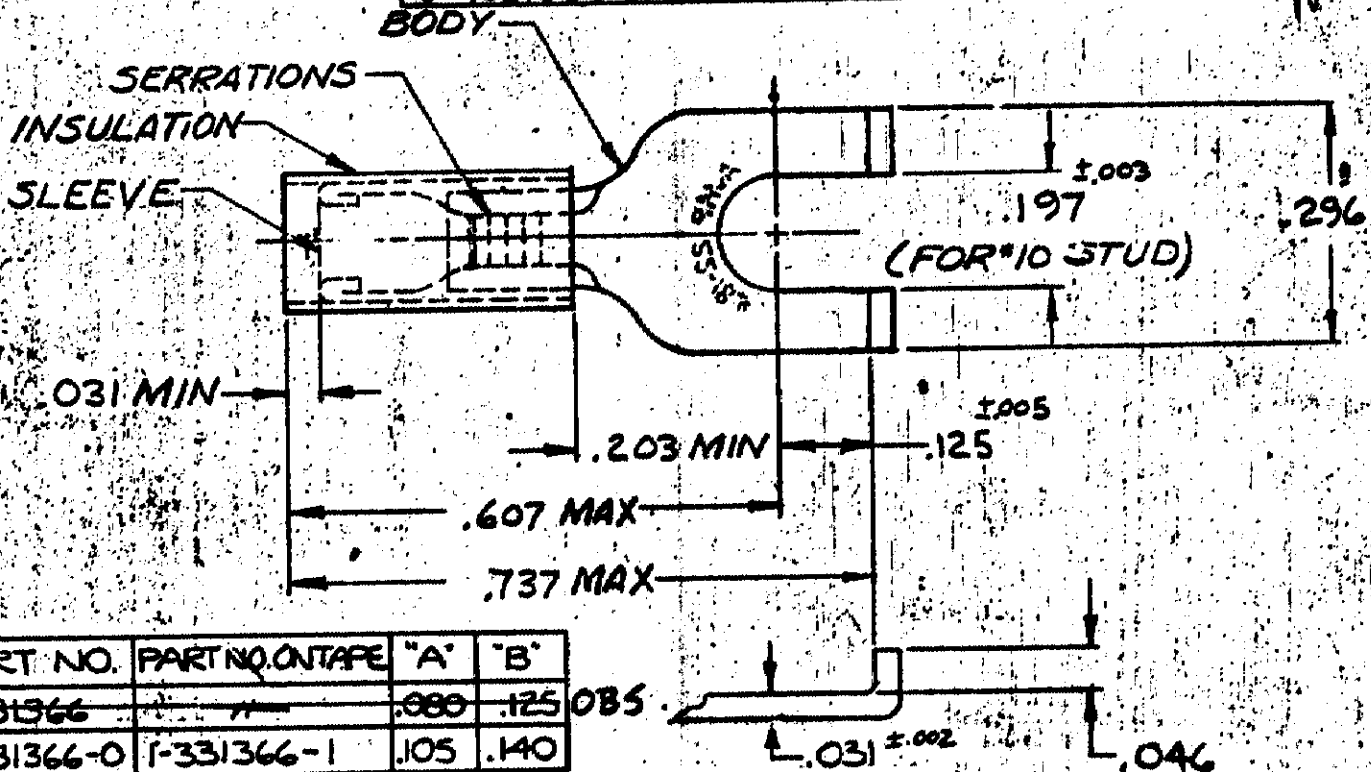

PART NO.	PART NO. ON TAPE	"A"	"B"
331366		.080	.125
1-331366-0	1-331366-1	.105	.140

FOR "A" TO "B" WIRE INS. DIA.  
MARKING 22-18 FOR MILITARY  
COMMERCIAL RANGE 22-16

1-331366-0 ON TAPE		1-331366-1	SLEEVE: COPPER (QQ-C-576)	
WIRE		1-331366-0	BODY: COPPER (QQ-C-576)	
Terminal		<del>331366</del> OBSOLETE	TIN PL (MIL-T-10727)	
QTY		DESCRIPTION	INSULATION: NYLON	
		PART NO	COLOR: RED	
			MATERIAL & FINISH	
UNLESS OTHERWISE SPECIFIED DIMENSIONS ARE IN INCHES. TOLERANCES ON: DECIMALS ±.008 ANGLES ±5°		CONTRACT NO.	AMP INCORPORATED HARRISBURG, PENNSYLVANIA	
MATERIAL		DR. <i>Stangor</i> 8-14-70	NAME WIRE TERMINAL	
SEE TABLE		CHE <i>M. Cunningham</i> 8-17-70	P.I.D.G.-FLANGED SPADE	
		APPD <i>L. Wabel</i> 8-17-70	WIRE SIZE: 22-16	
		REL <i>H. Young</i> 8-17-70		
		DSGN APPD	SIZE A	CODE IDENT NO. 00779
		OTHER APPD	NUMBER 331366	
			SCALE NTS	SHEET 1 OF 1

# Mouser Electronics

Authorized Distributor

Click to View Pricing, Inventory, Delivery & Lifecycle Information:

[TE Connectivity:](#)

[1-331366-1](#)