


MADE IN AMERICA PROJECTION

BY AMP INCORPORATED, ALL RIGHTS RESERVED. NO PARTS MAY BE REPRODUCED OR TRANSMITTED IN ANY FORM OR BY ANY MEANS WITHOUT WRITTEN PERMISSION OF AMP INCORPORATED.

REVISIONS

| LTR | DESCRIPTION | DATE | APPROVED |
|-----|--------------------|-------------|------------|
| O | NPS 74-0337 | PM 6-4-74 | <i>Jim</i> |
| A | REVISED ECN P-7424 | PM 12/20/74 | L.D. |
| B | INACT P9268 | 12/13/82 | <i>Jim</i> |
| C | OBS -4 REV G 2589 | BT 10-12-87 | <i>pgm</i> |

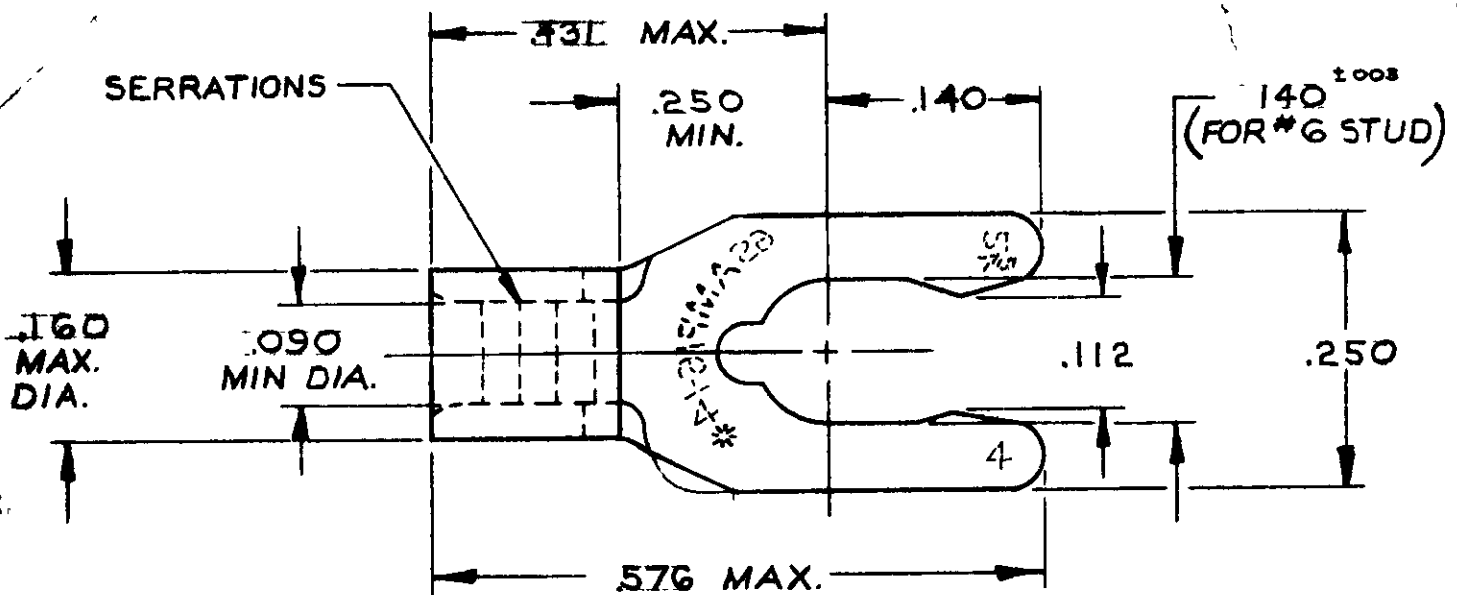

TONGUE MATERIAL THK. = .031 ±.002

INACTIVE
P9268
Jim
12-13-82

ENGINEERING CONTROLLED

~~OBSOLETE~~ ~~53010-4~~ 53010-3

PART NO ON TAPE PART NO

UNLESS OTHERWISE SPECIFIED DIMENSIONS ARE IN INCHES
TOLERANCES ON:
DECIMALS ±.008
ANGLES ± 5°

MATERIAL
PHOSPHOR
(MIL-E-576)
TIM PLATED
(MIL-T-10727)

CONTRACT NO. H
DR. Phil Monaghan 5-30-74
CHK. *Jim* 6-4-74
APPD. Les Abel 6-5-74
REL. Phil Monaghan 8-5-74
DSGN APPD. *Jim* Brown 6-4-74
OTHER APPD.



AMP INCORPORATED
HARRISBURG, PENNSYLVANIA

NAME
WIRE TERMINAL
BUDGET - SPRING SPADE (SHORT)
WIRE SIZE: 16-14

SIZE A CODE IDENT NO. 00779 NUMBER 53010

SCALE N.T.S. SHEET 1 OF 1

Mouser Electronics

Authorized Distributor

Click to View Pricing, Inventory, Delivery & Lifecycle Information:

[TE Connectivity:](#)

[53010-1](#)