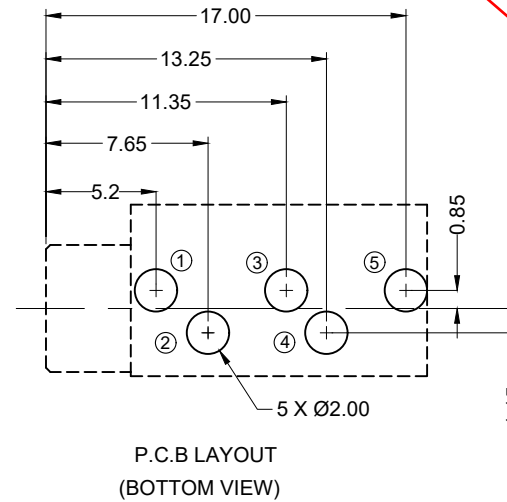
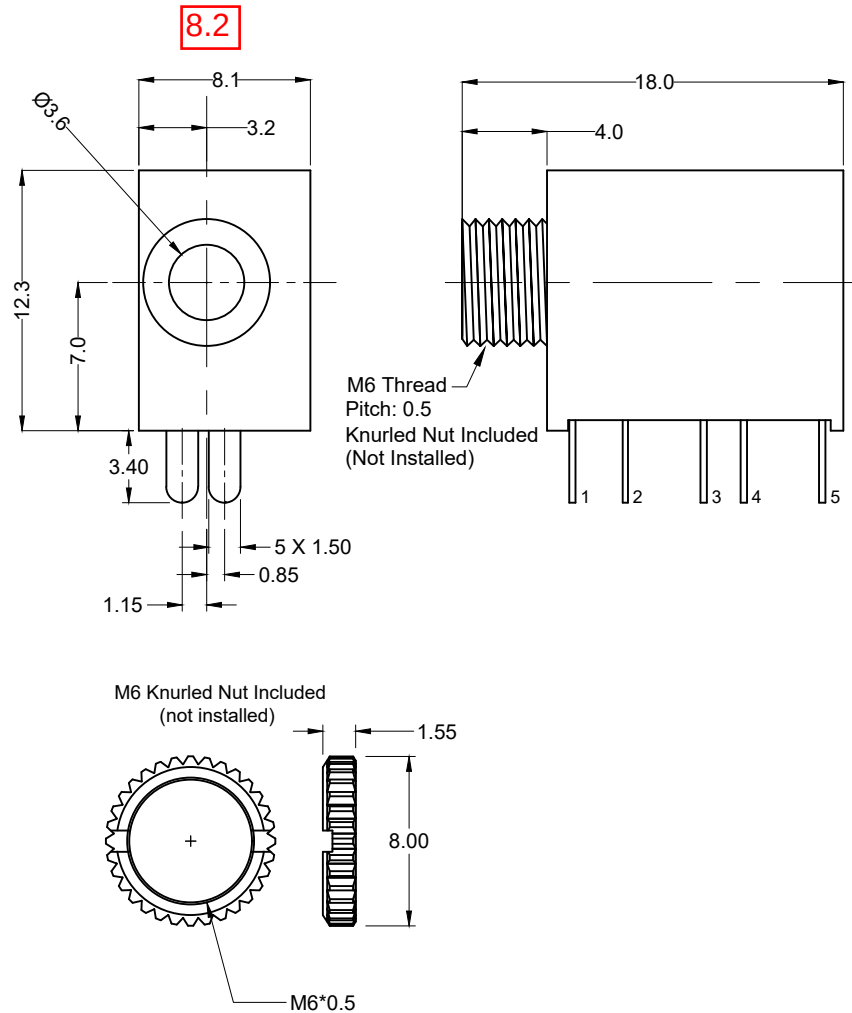


Materials and Finish

Housing: PBT Thermoplastic
UL 94V-0 Rated, Black Color

Contact Material:

Pin #1: Brass, Matte Tin Plated

Pin #2 and Pin #4:
Phosphor Bronze, Matte
Tin Plated

Pin #3 and Pin #5:
Brass, Matte Tin Plated

Switch Contacts:
Brass, Matte Tin Plated

Electrical Characteristics

Insulation Resistance:
100 Megohms at 500V DC

Contact Resistance:
50 milliohms Max.

Dielectric Withstanding Voltage:
500V AC RMS for 1 Minute

Mechanical Characteristics

Insertion Force: 0.3kg - 3.0kg

Withdrawal Force: 0.3kg - 3.0kg

Durability: 5000 Mating Cycles Min.


Operating Temperature:
-25°C to +85°C

RoHS COMPLIANT



Tolerances	
X.X ± 0.30	
X.XX ± 0.15	
Unless Stated Otherwise	

REV.	DATE	DESCRIPTION	REV. BY	CHK. BY	DRAWN BY	DATE
A0	03/29/18	New Drawing	G. Serrato	C. Furumasu	G. Serrato	03/29/18
A1	11/07/18	Release Drawing DC18-009	D. Shehan	C. Kelleher		

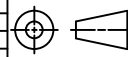

STX-3150-5C-1

Stereo Jack, Straight Black Cover, 5 Pos

Thread w/ Nut, RoHS Compliant



Mouser Electronics

Authorized Distributor

Click to View Pricing, Inventory, Delivery & Lifecycle Information:

[Kycon:](#)

[STX-3150-5C-1](#)